


AS BUILT 3 TENANT SPACES DIVISIBLE

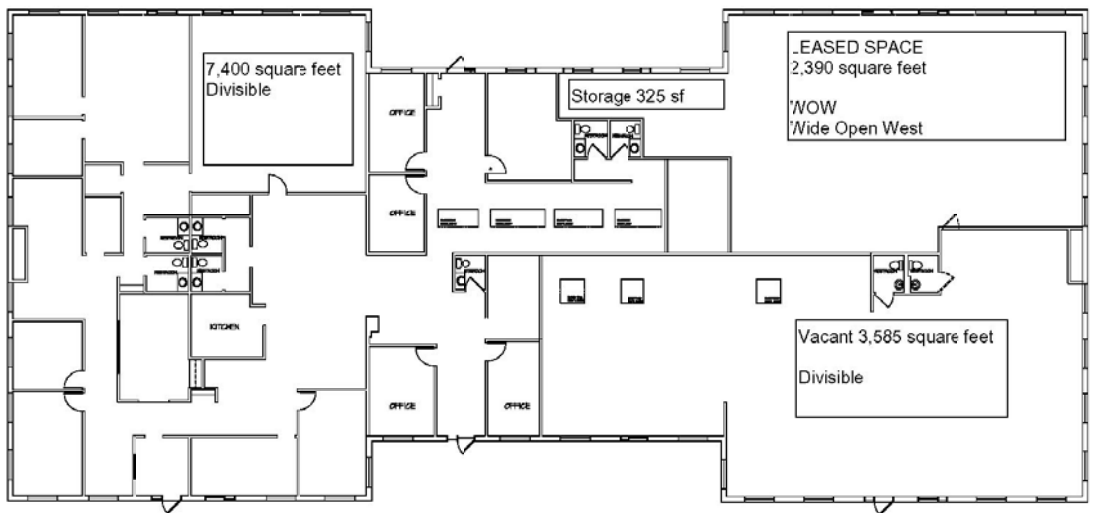

FLOORPLAN OF BUILDING 3
STONEHILL SQUARE
SCALE 3/16" = 1'-0"

